


**NOTE**

This drawing is copyright and must not be reproduced in whole or in part for any purpose without the Architect's permission. It is based on surveys by others and no responsibility is accepted for accuracy. It must be read with the rest of the Contract documents and errors and omissions must be notified to the Architect before work is commenced or orders placed. Spec & Schedule references do not exclude other relevant clauses.

No.	Revision/Issue	Date
B	Revised for Phase 2	14.4.15
C	Revised for as built record and Yetl added	4.4.16

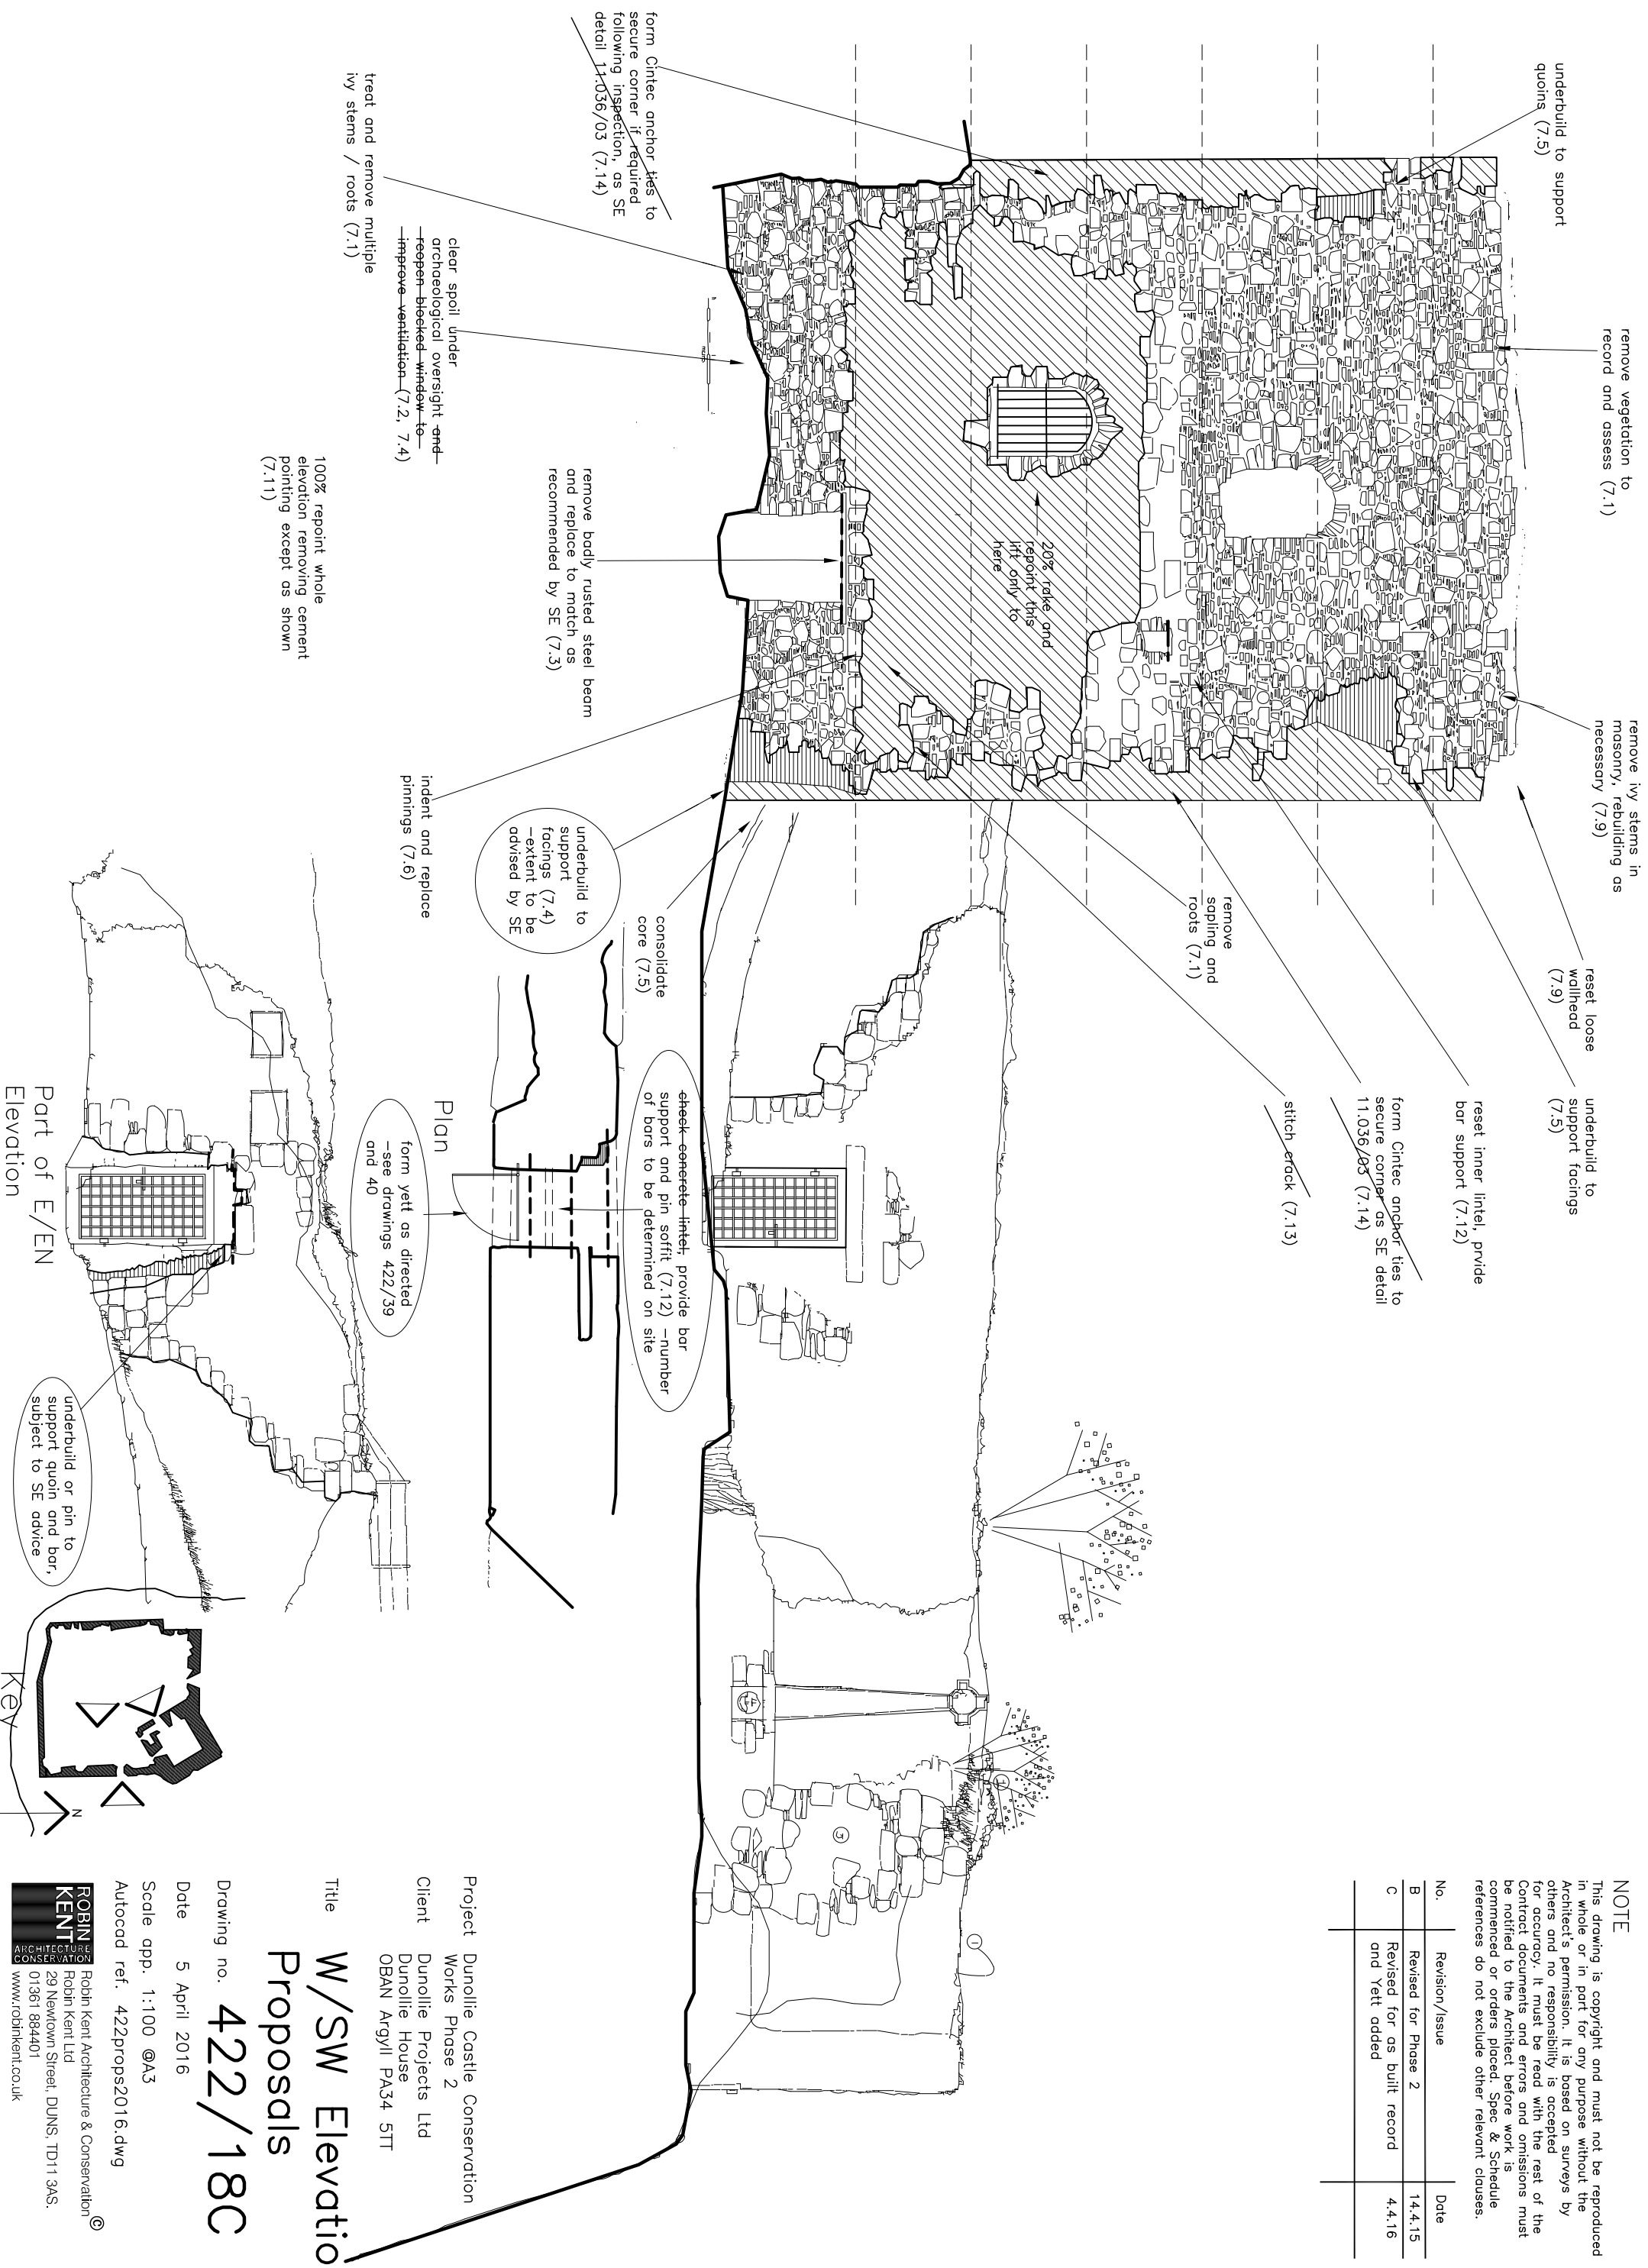

**Project** Dunollie Castle Conservation Works Phase 2  
**Client** Dunollie Projects Ltd  
 Dunollie House  
 OBAN Argyll PA34 5TT

**Title**  
**W/SW Elevation Proposals**

**Drawing no.** 422/18C  
**Date** 5 April 2016  
**Scale** app. 1:100 @A3  
**Autocad ref.** 422props2016.dwg

**ROBIN KENT ARCHITECTURE & CONSERVATION**  
 Robin Kent Architecture & Conservation  
 Robin Kent Ltd  
 29 Newtown Street, DUNS, TD11 3AS.  
 01361 884401  
 www.robinkent.co.uk