

REFER TO
DETAIL 1

30 ϕ M.S.PIN
GALVANISED

2230


END TO BE
BLUNT ROUNDED

PIN DETAIL
(1:20)

100x100x100lg.
WITH 25 ϕ HOLE
x100lg.


CUBE WELDED
TO PIN

DETAIL '1'

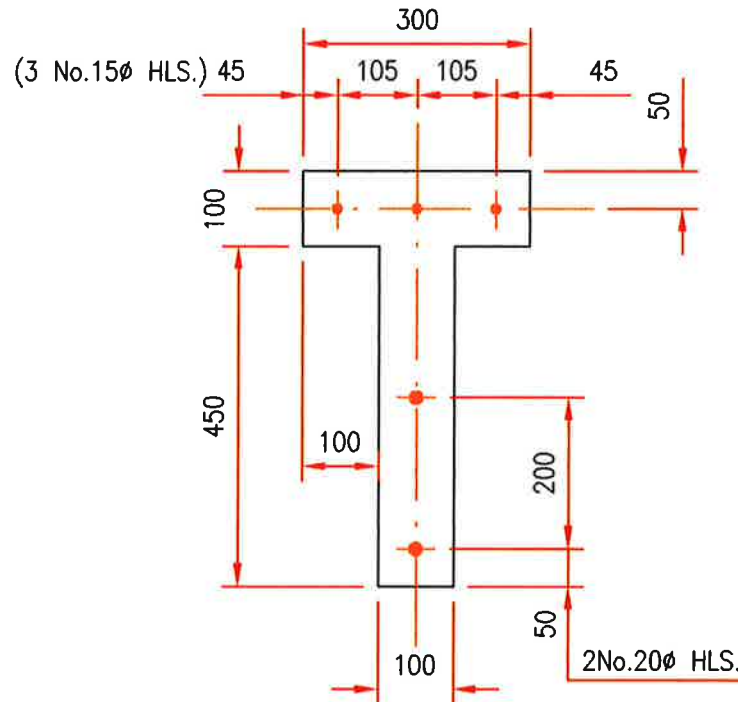

10thk.M.S.FLT.
GALVANISED

DETAIL OF 'T' PIECES

R	APR. '01	AS BUILT	A.W.W.	G.McB
REV	DATE	DESCRIPTION	BY	APP.
			ENGINEER SCOTLAND CANAL HOUSE APPLECROSS STREET GLASGOW G4 9SP	
			UNION CANAL SAFETY GATES RESTRAINING PINS & 'T' PIECES	
DRAWN BY		A.W.W.	SCALES :-	1:1
CHECKED BY			DATE	
APPROVED BY			July '99	
		DRAWING No.	WSG2	
		REV.	R	