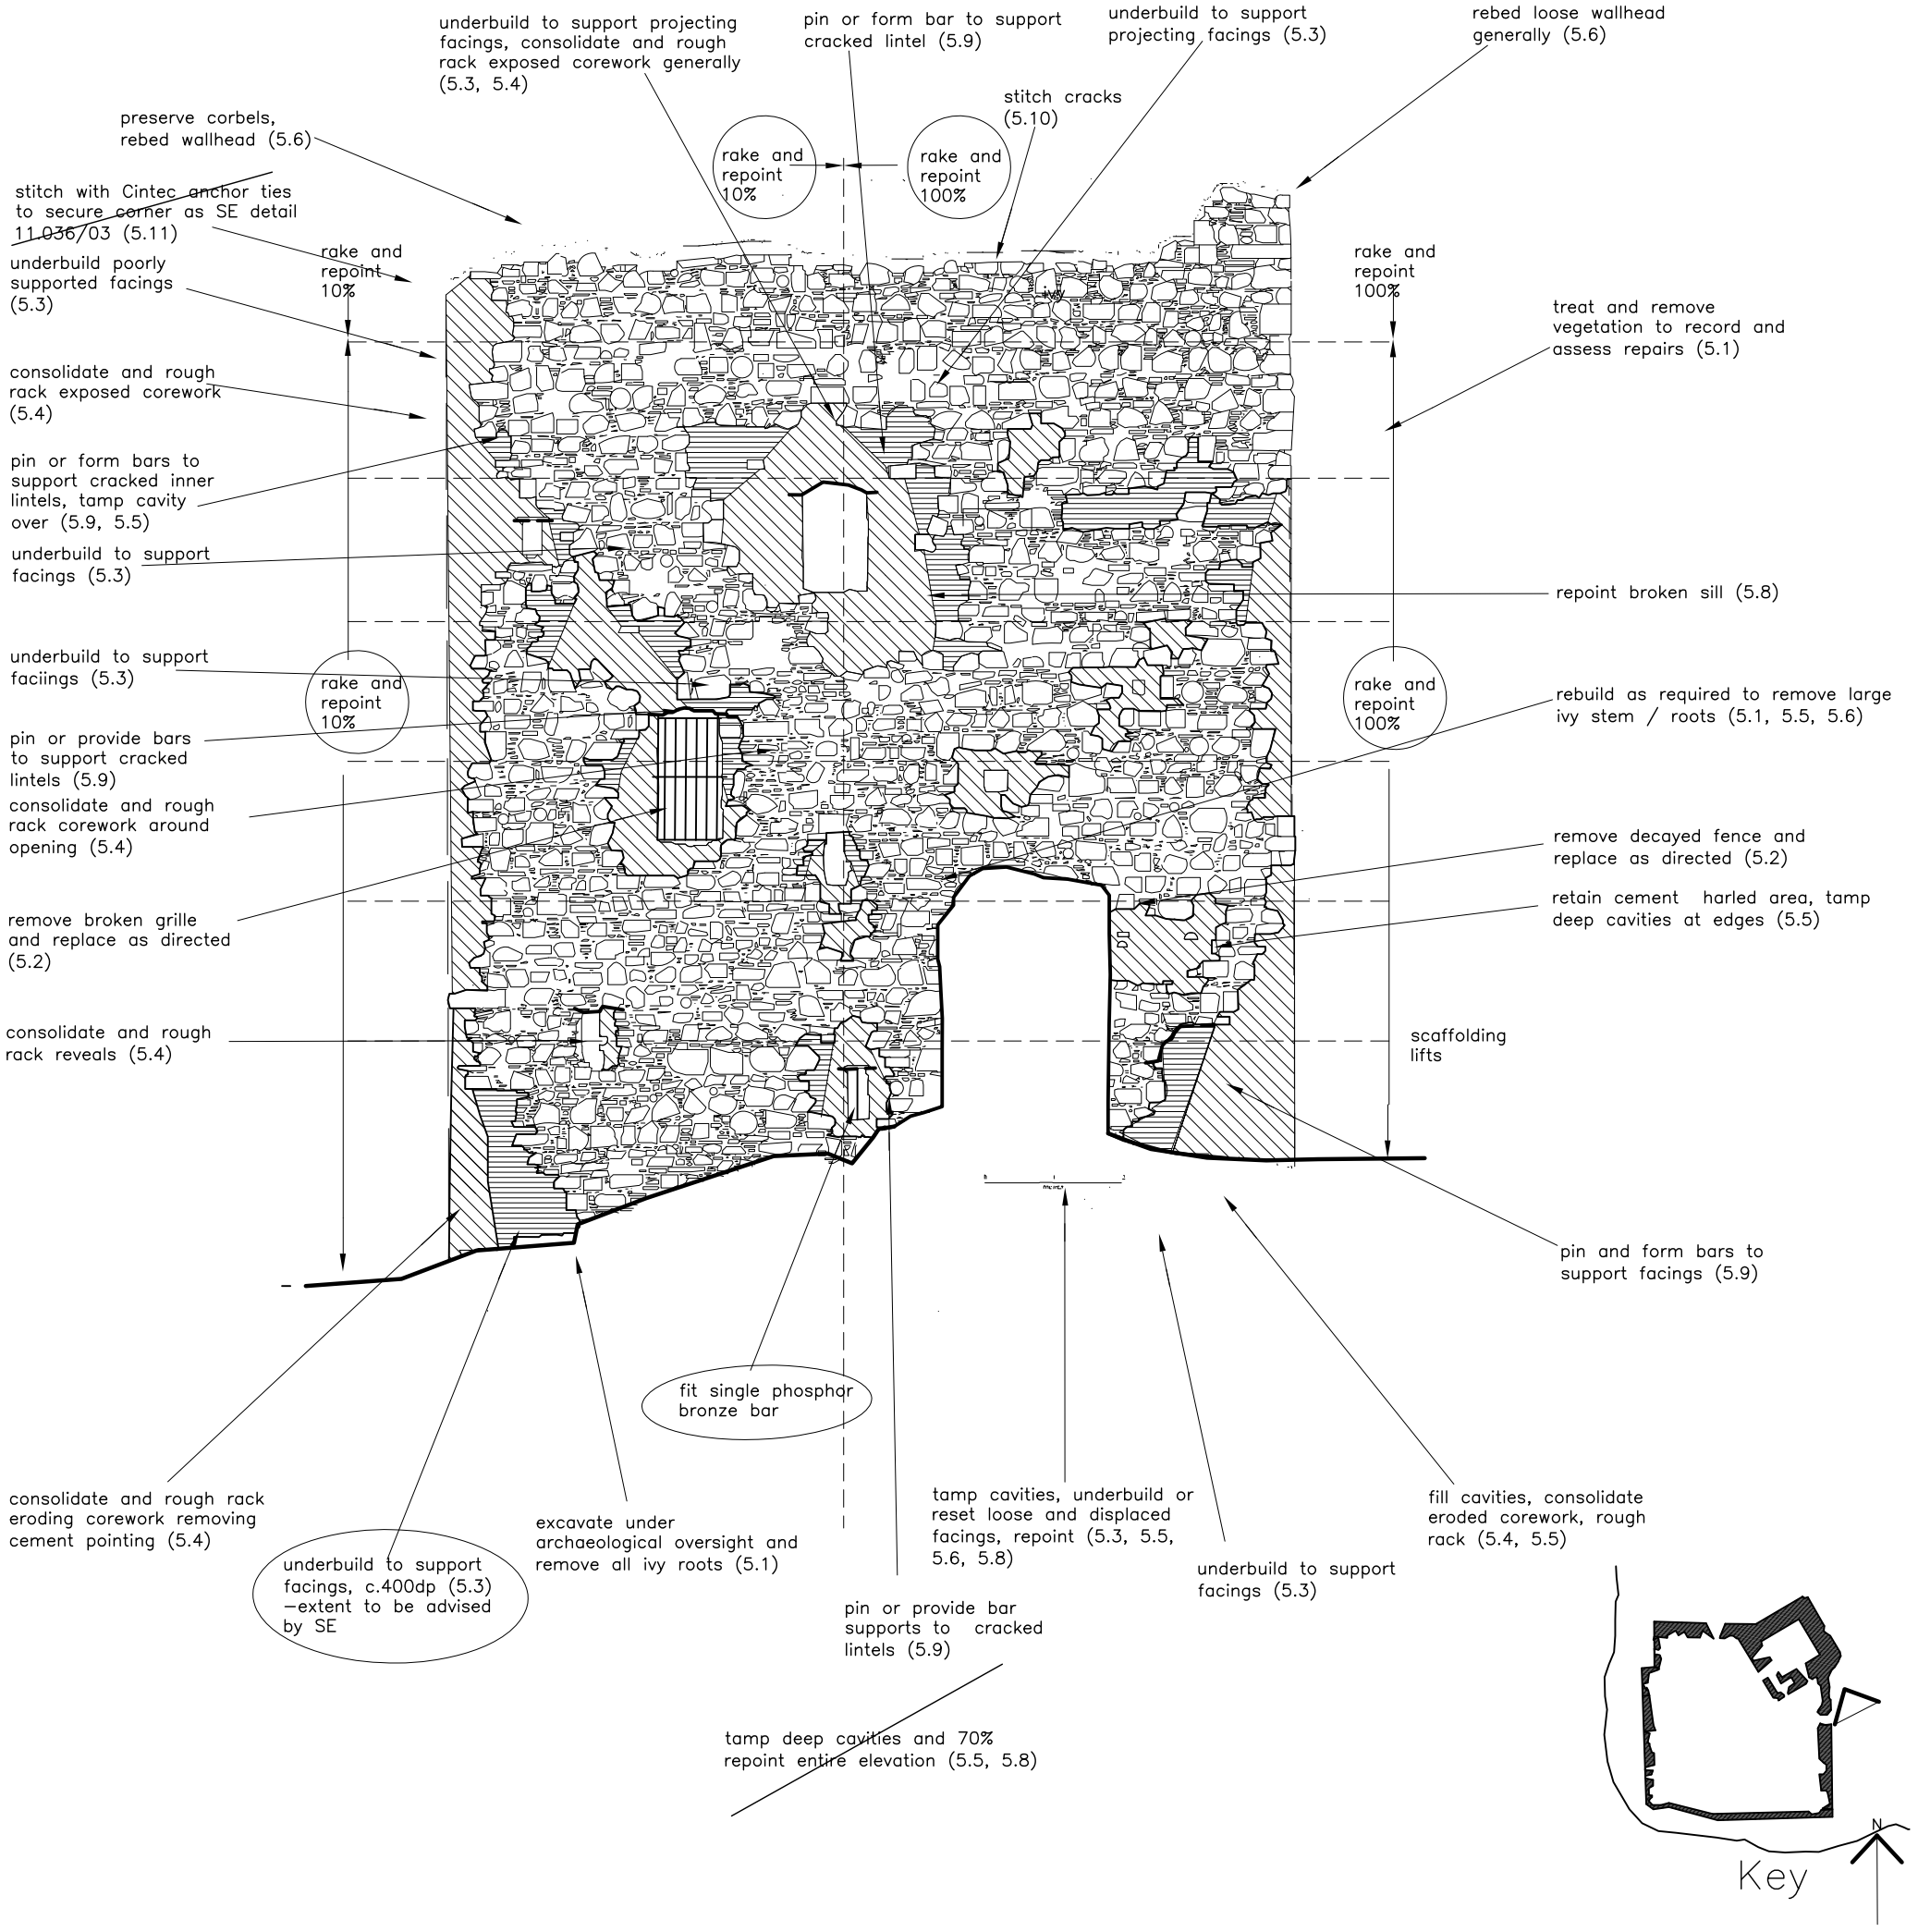

NOTE

This drawing is copyright and must not be reproduced in whole or in part for any purpose without the Architect's permission. It is based on surveys by others and no responsibility is accepted for accuracy. It must be read with the rest of the Contract documents and errors and omissions must be notified to the Architect before work is commenced or orders placed. Spec & Schedule references do not exclude other relevant clauses.

No.	Revision/Issue	Date
B	Revised for Phase 2	14.4.15
C	Revised for as built record	4.4.15

KEY

- Treat and remove all vegetation, ivy and roots, to enable recording and assessment of masonry repairs (Spec C40, Drg 422/30)
- Consolidate and rough rack corework / wallhead (Spec F15, Drgs 422/31, 32)
- Rebed / rebuild facings (Spec F20, Drgs 422/31 and 32)
- Indent missing or failed stone(s) and pinnings to restore support (Spec F35, Drg 422/32)
- Underbuild corbelled corework to support facings (Spec F16, Drg 422/34)
- Consolidate and form soft capping to shed water (Spec F17, Drg 422/31)
- Stitch cracks, pin or form bars to support cracked lintels and loose stones (Spec F19, Drg 422/33, 34)

Project Dunollie Castle Urgent Repair Works: Phase 2

Client Dunollie Projects Ltd
Dunollie House
OBAN Argyll PA34 5TT

Title **S/SE Elevation Proposals**

Drawing no. **422/16C**

Date 5 April 2016

Scale app. 1:100 @A3

Autocad ref. 422props2016.dwg

Robin Kent Architecture & Conservation©
Robin Kent Ltd
29 Newtown Street, DUNS, TD11 3AS.
01361 884401
www.robinkent.co.uk